
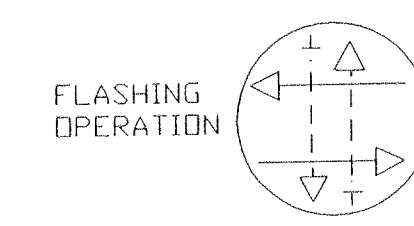
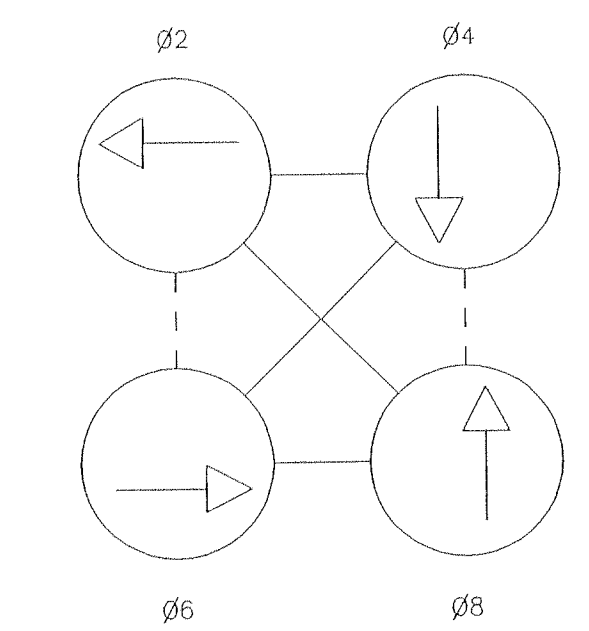
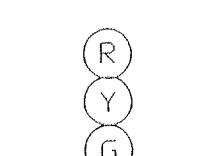


| F H WA REGION NO | STATE | FED. AID PROJ. NO | SHEET NO. | TOTAL SHEETS |
|---------------------|-------|----------------------|--------------|-----------------|
| 3 | MD. | | | |

EXISTING
SIGNALS

PROPOSED
SIGNALS

NEMA PHASING

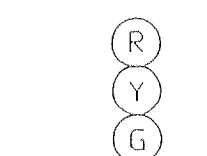


PROPOSED
SIGN

9a, 9b

SECOND STREET


D 3-2 DUAL FACED
16" X VAR.

PHASES ASSOCIATED BY A DASHED LINE WILL OPERATE CONCURRENTLY
PHASES ASSOCIATED BY A SOLID LINE WILL NOT OPERATE CONCURRENTLY

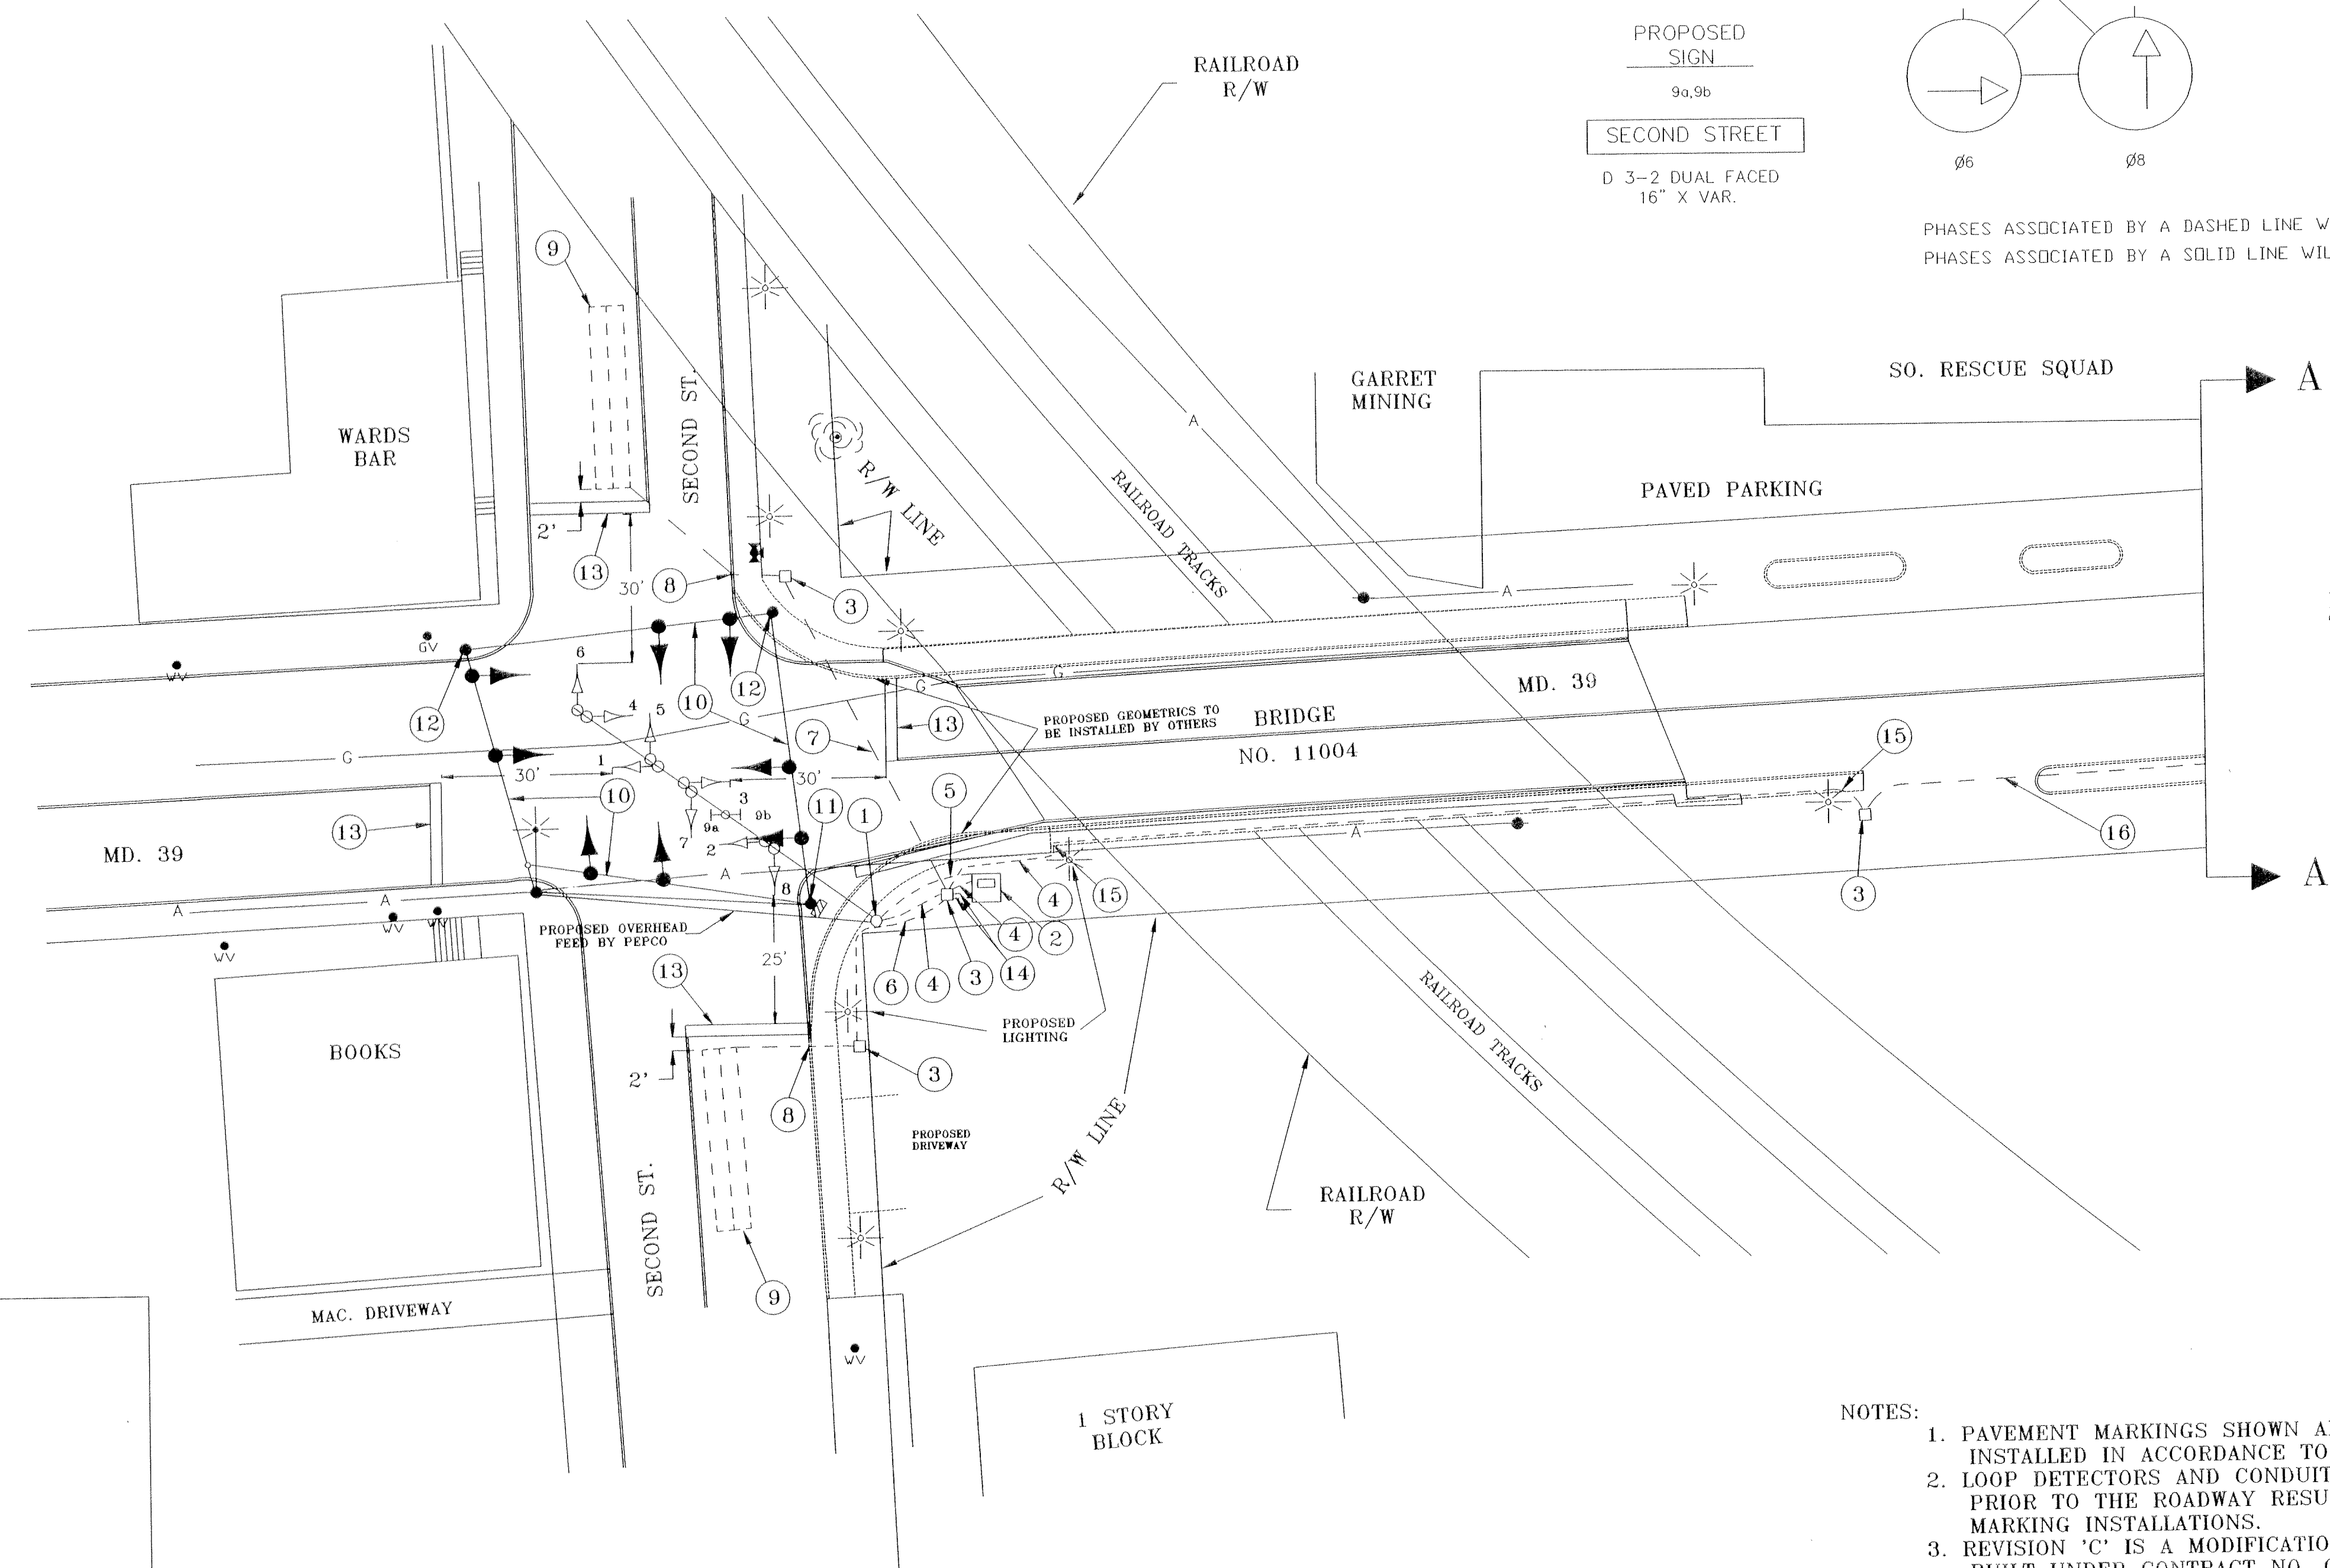

NOTES:

1. PAVEMENT MARKINGS SHOWN ARE PROPOSED AND TO BE INSTALLED IN ACCORDANCE TO S.H.A. STANDARDS.
2. LOOP DETECTORS AND CONDUITS ARE TO BE INSTALLED PRIOR TO THE ROADWAY RESURFACING AND PAVEMENT MARKING INSTALLATIONS.
3. REVISION 'C' IS A MODIFICATION TO THE EXISTING SIGNAL BUILT UNDER CONTRACT NO. G-363X-675 IN MAY 1972
4. CONTRACTOR SHALL VERIFY LOCATION OF NEW GEOMETRICS PRIOR TO POLE AND CABINET INSTALLATION

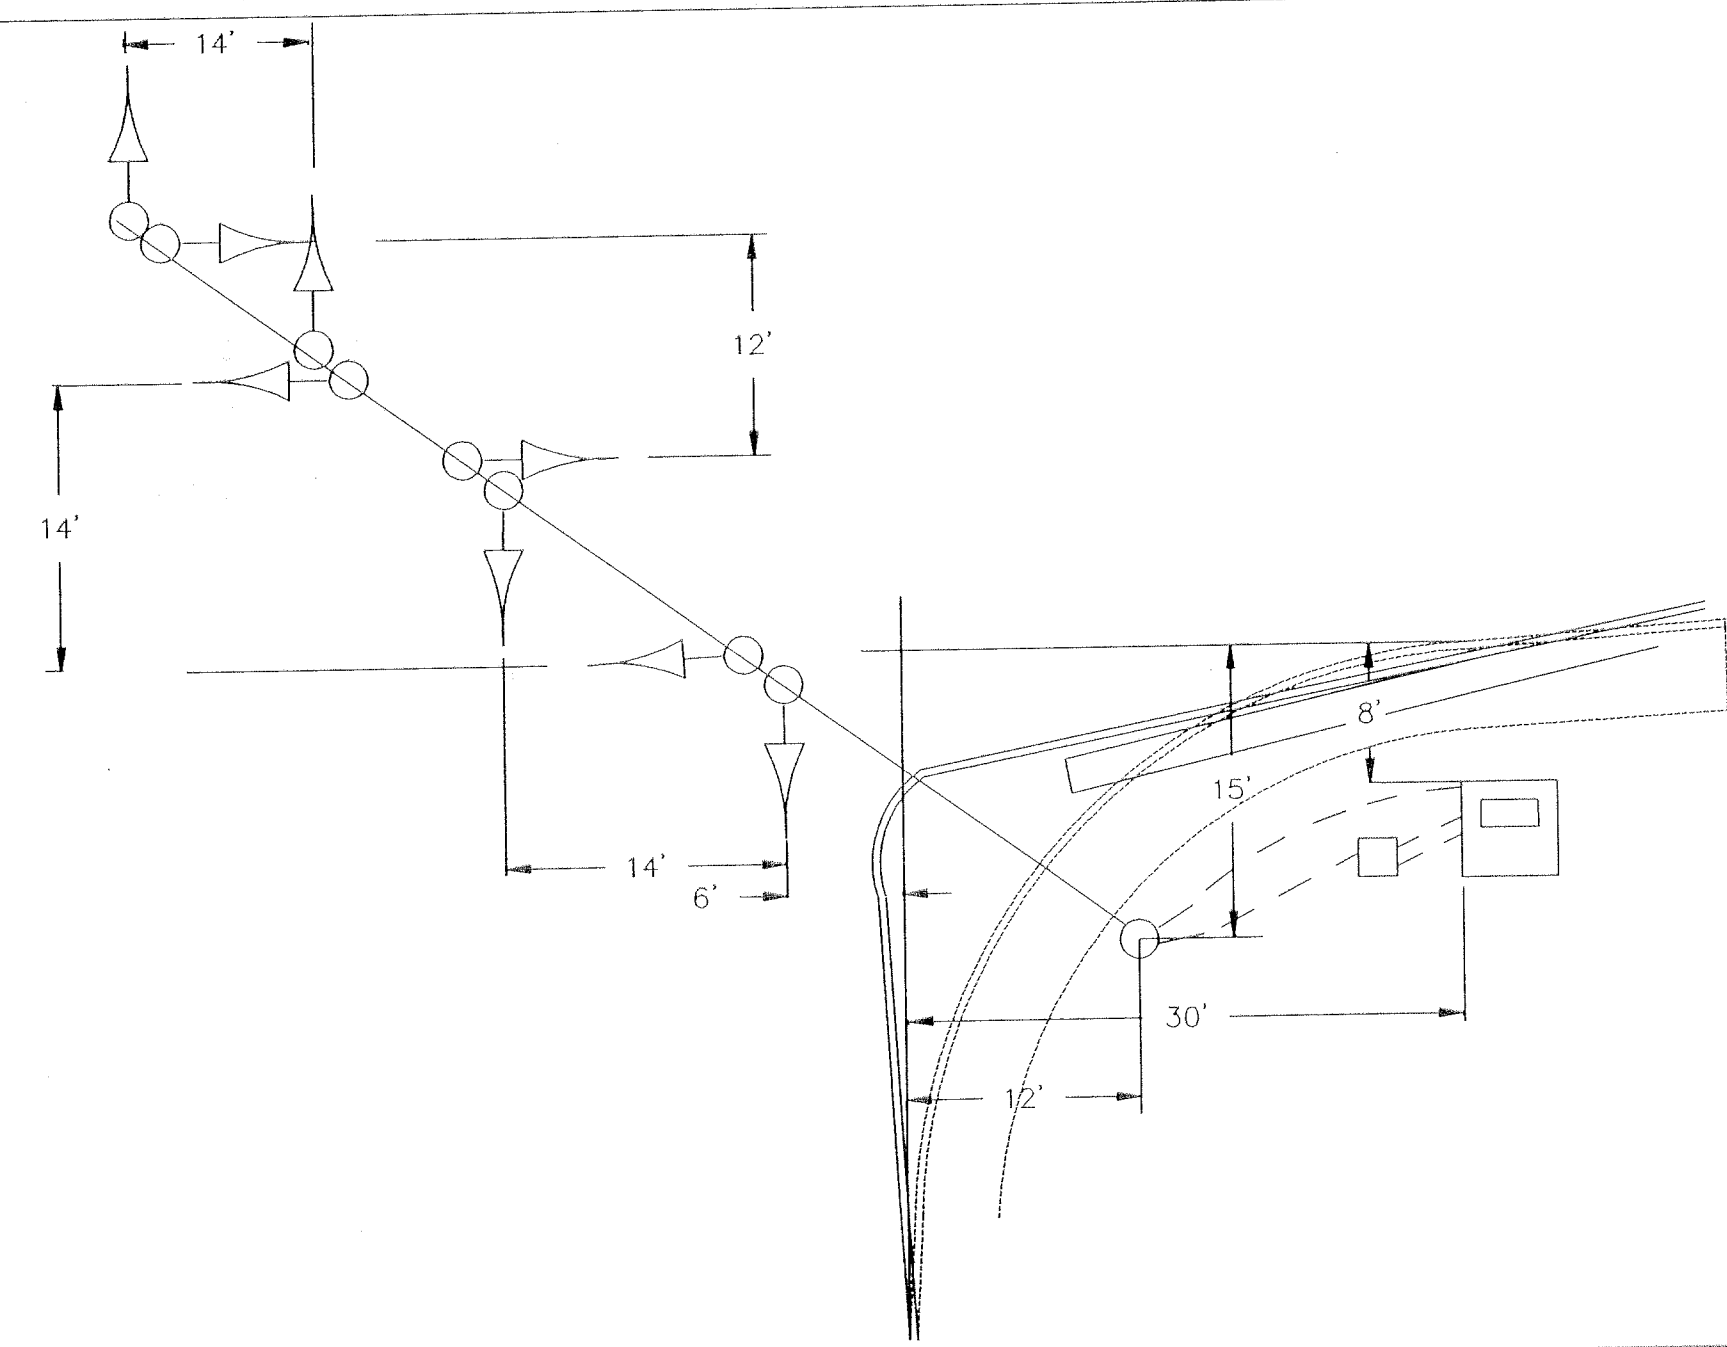

| | | | | | | | |
|---|--|---|--|--|--|--|--|
| REVISIONS 9-01-92 REBUILT AND INSTALL INTER- CONNECT / NEW GEOMETRICS MAR 1992 6-12-74 ASBUILT & REDRAWN 4-10-73 REVISED CONTRACT NO. FROM G-363X-665 TO G-363X-675 JB | | APPROVALS ORIGINAL CHIEF, SIGNAL DESIGN SECTION ON ASST. DISTRICT ENGINEER, TRAFFIC CHIEF, TRAFFIC ENGINEERING DESIGN DIVISION FILE DIRECTOR, OFFICE OF TRAFFIC & SAFETY | | MDOT - STATE HIGHWAY ADMINISTRATION OFFICE OF TRAFFIC & SAFETY TRAFFIC ENGINEERING DESIGN DIVISION DRAWN BY: J. DUFFY (REDRAWN MAR) DES. BY: CHK. BY: DATE: 05-04-72 SCALE: 1" = 20' F.A.P. NO. S.H.A. NO. G-363X-675 SIGNAL # 11003906.12 COUNTY: GARRETT TS/STD. NO. TS-406 © SHEET NO. OF | | | |
|---|--|---|--|--|--|--|--|

11003906.12 F#25